


AS-BUILT PLANS 12/12/12

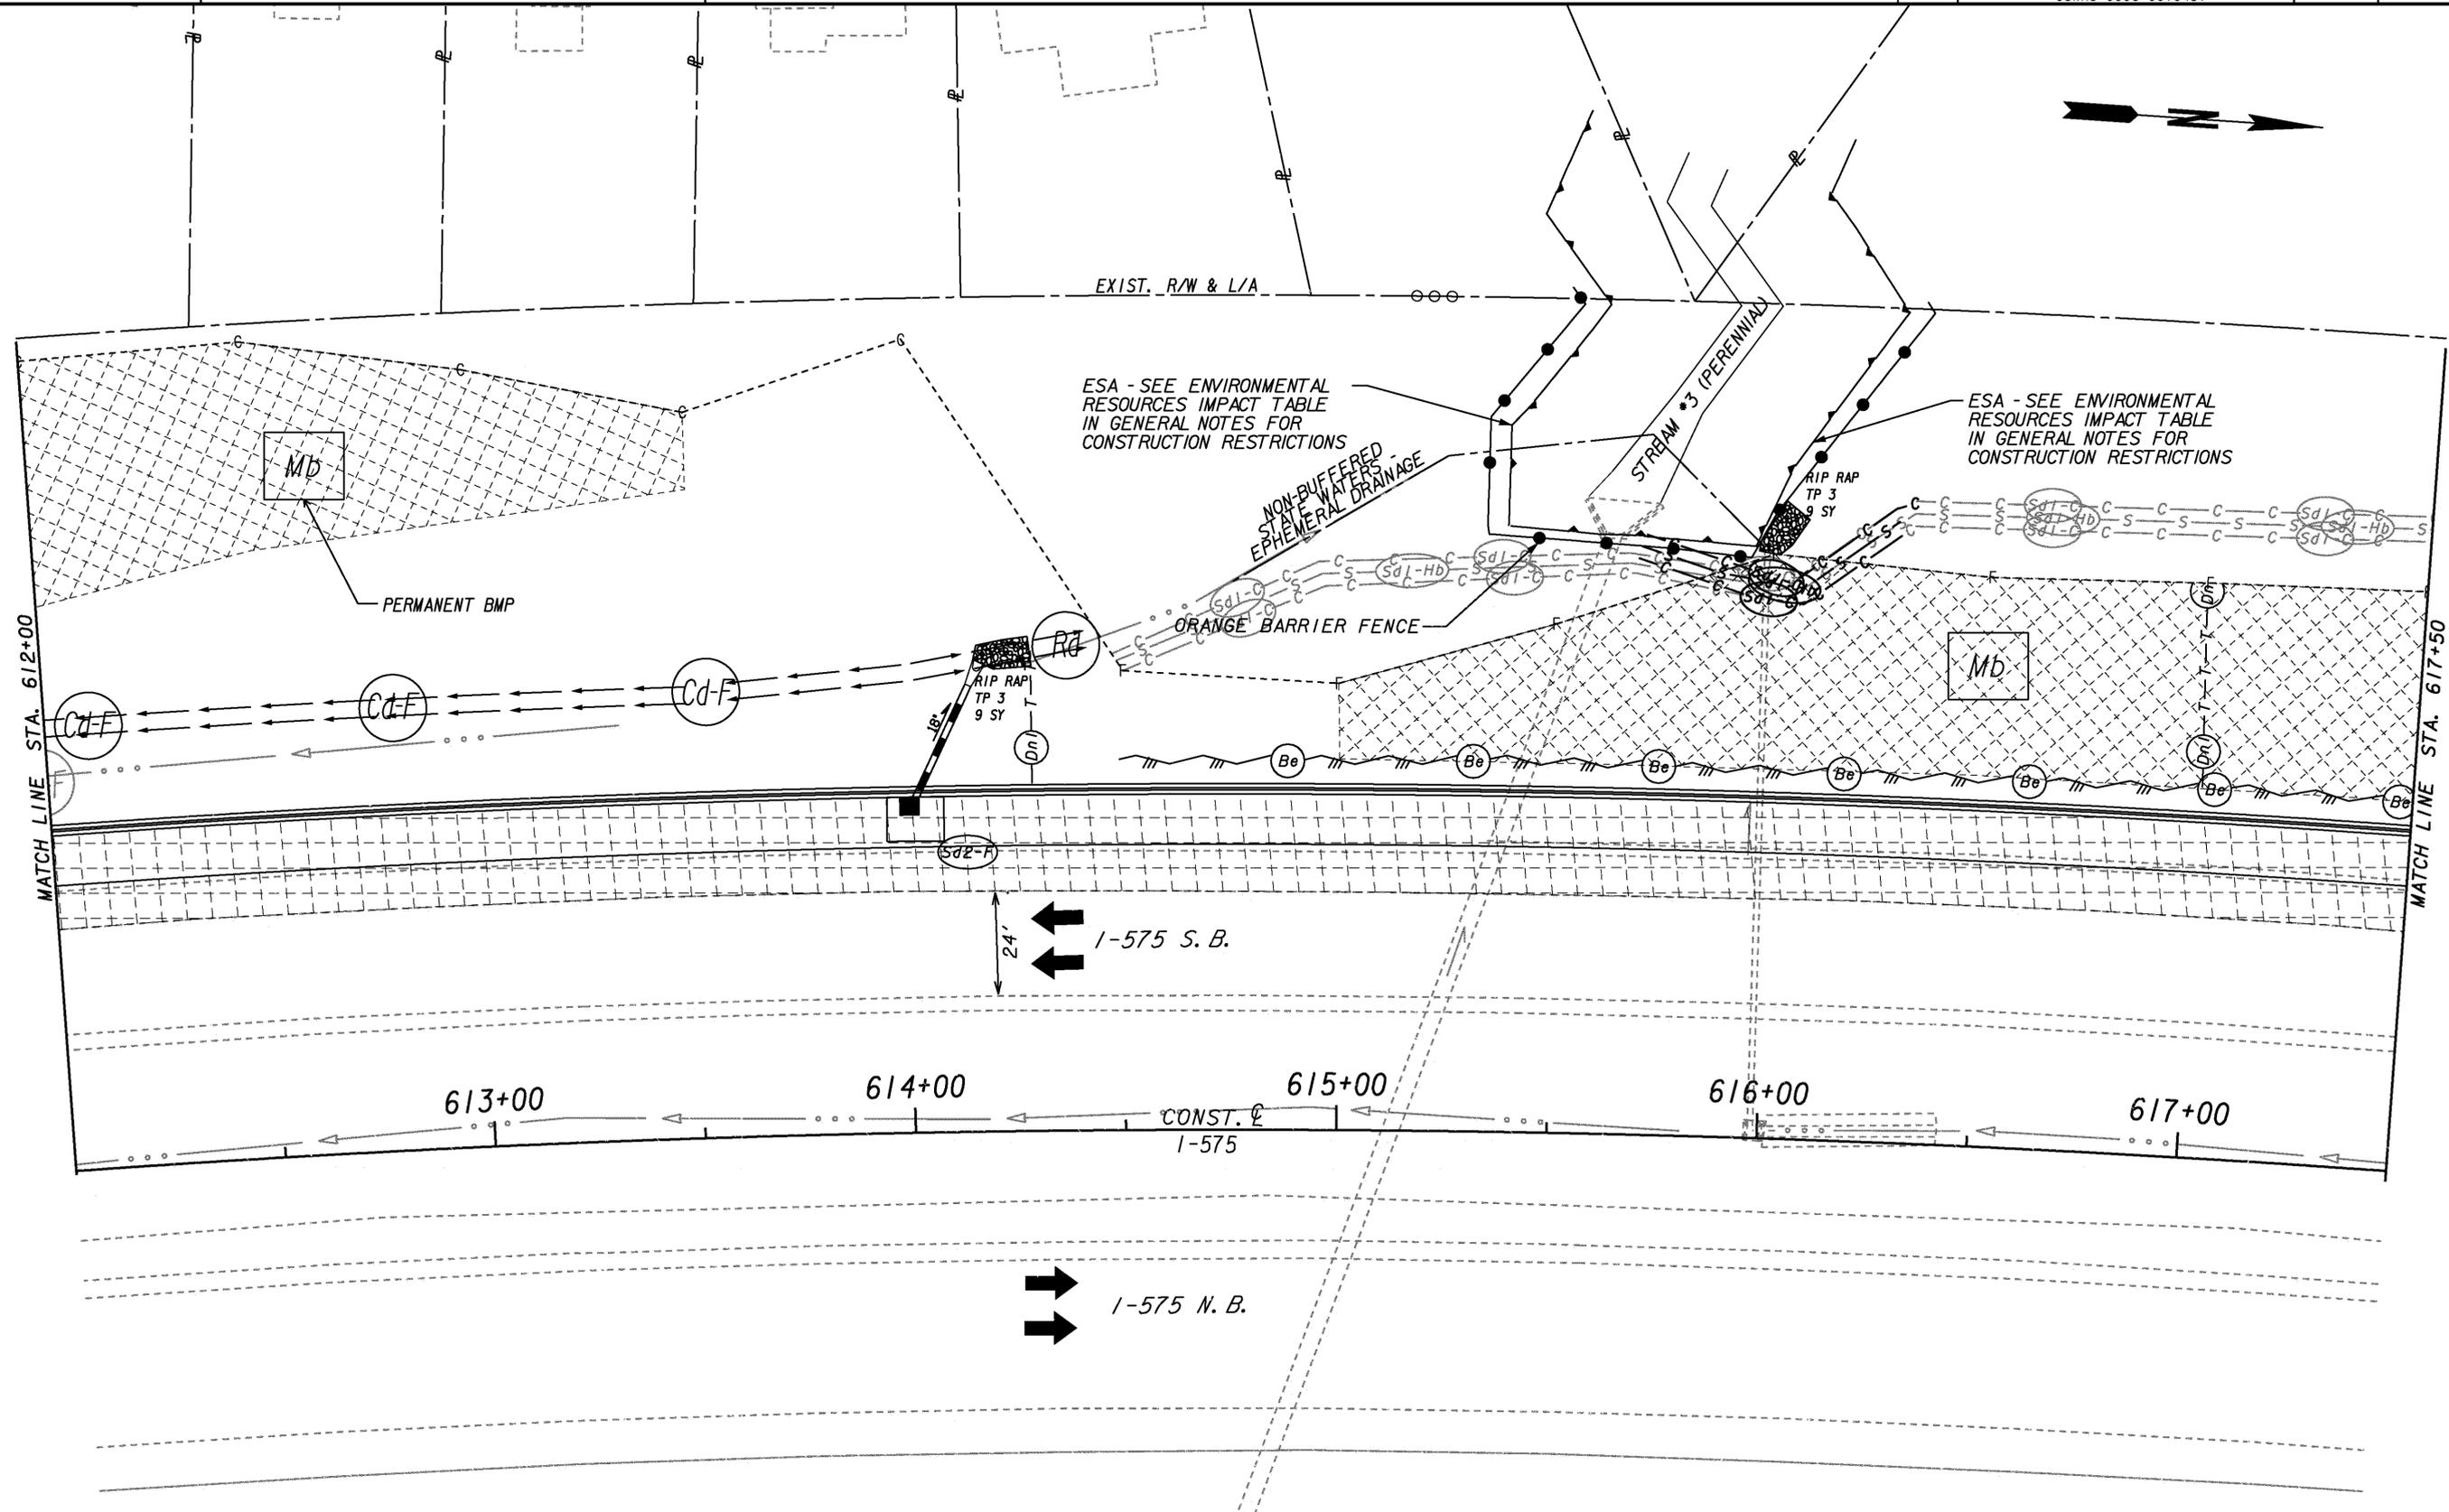

LEGEND

- PAVEMENT REMOVAL
- TEMPORARY CONSTRUCTION PAVEMENT
- PERMANENT CONSTRUCTION
- CONCRETE MEDIAN CONSTRUCTION
- MILL & OVERLAY CONSTRUCTION
- OPEN LANES OF TRAFFIC

THE LPA GROUP
TRANSPORTATION CONSULTANTS

3595 ENGINEERING DRIVE
NORCROSS, GEORGIA 30092
(770) 263-9118



REVISION DATES

NO.	DATE	DESCRIPTION

STATE OF GEORGIA
DEPARTMENT OF TRANSPORTATION
OFFICE: INNOVATIVE PROGRAM DELIVERY

BMP LOCATION DETAILS
INTERMEDIATE PHASE
I-575 SB AUXILIARY LANE
STA. 612+00 TO STA. 617+50

DRAWING No. **54-044**